


This drawing is copyright and may not be reproduced without the written authority of the copyright owner.

REVISIONS

NO.	DESCRIPTION	DATE
A	As issued	14/07/2017
B	As issued	22/07/2017
C	As issued	14/07/2017
D	As issued	14/07/2017
E	As issued	14/07/2017
F	As issued	14/07/2017

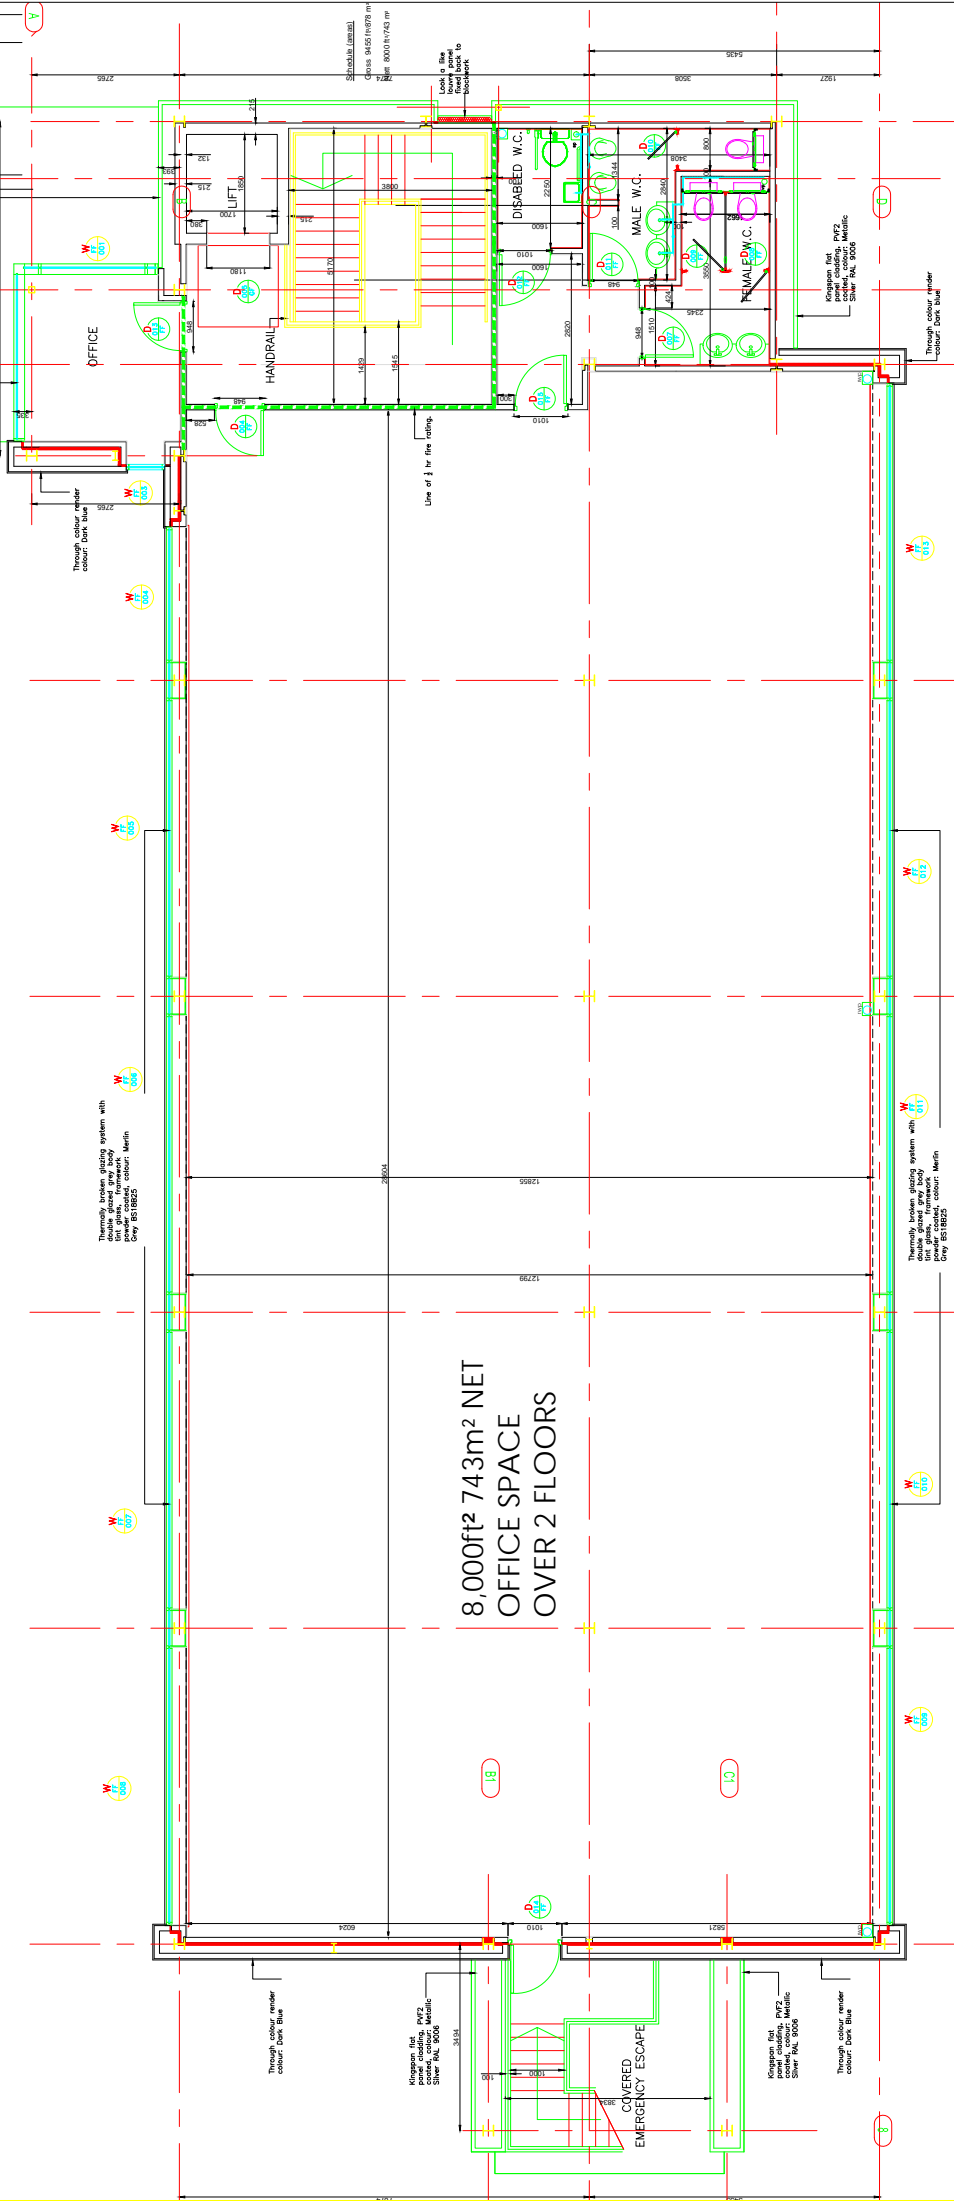

Proposed Development
 Site
 Smithywood
 Sheffield
 Plot G

AS BUILT

SI Plural Developments

Title: **Plot G Unit 5 First Floor Plan**

Client: **SI Plural Developments**

Contract No: **6462**

Year: **2010**

Scale: **E**

Date: **Feb. 07**

Drawn by: **MJM**

Checked by: **J. 60017-0006462**

2, ST JOHN'S NORTH
 TAUNTON, SOMERSET
 TA10 2JH
 Tel: (01274) 201600
 Fax: (01274) 200272
 Email: enquiries@harris-architects.co.uk
 Website: www.harris-architects.co.uk

Office also at:
 10, Market Street, Reading, RG1 1AA

Architects

First Floor Scale 1:50